
FEBRUARY

SW- 03 - Concrete Manhole -2 Each

SW- 07 - 21" VCP Sewer -252 LF

SW-13 - 6" or 8" Diameter side sewer connection- 1 Each




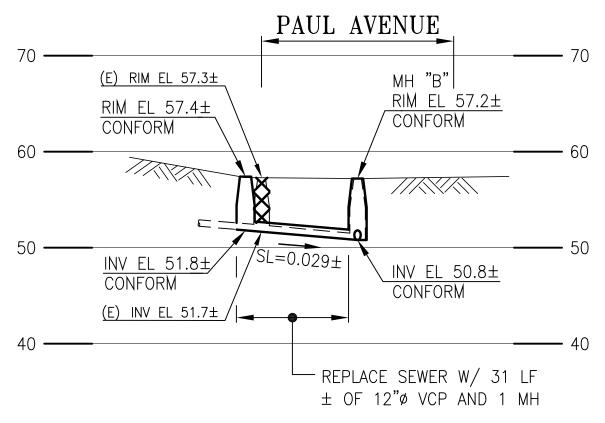


PROFILE "D" (LOOKING WEST) SCALE: HORIZ 1"=30' VERT 1"=10'

- REPLACE 12"ø ISP REPLACE 12"Ø ISP SEWER W/ SEWER W/ 21"ø VCP. 一凡 (TYP) 18" VCP. SEE PROFILE "C" -SEE PROFILE "C" 6"ø OR 8"ø SS CONNECTION (TYP) — CURB (TYP) /─ MH "B" 400 - BLYSHORE 425 WHEAT STREET CRANE SS Ø 8 80 (AAL) -REPLACE 8"Ø ISP SEWER W/ -REPLACE 8"Ø ISP SEWER W/ 12"ø VCP. SEE PROFILE "D" 12"ø VCP. SEE PROFILE "C" - SEE MH CONNECTION DETAIL 1 — SEE MH CONNECTION DETAIL 1 199' PLAN

PAUL AVENUE

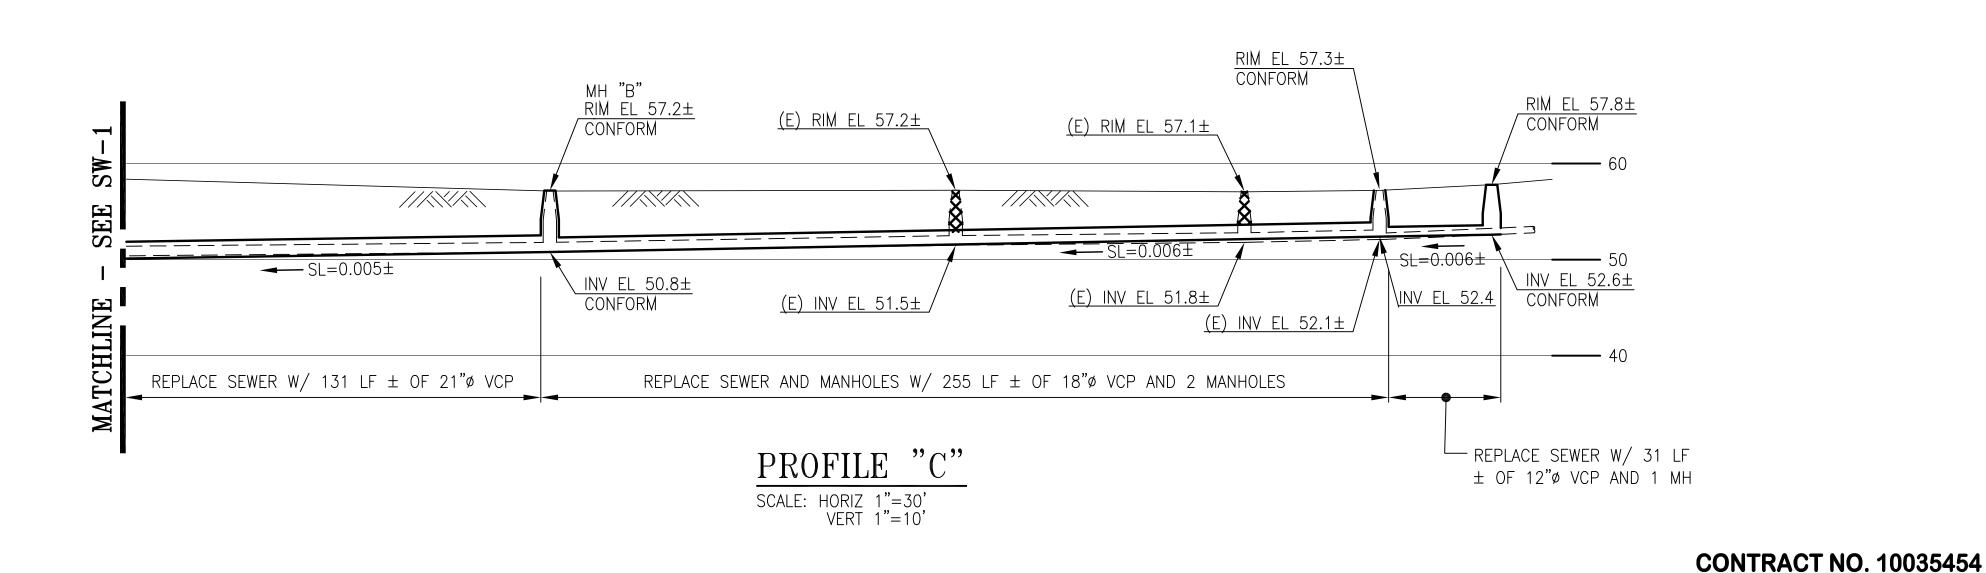

SCALE: 1"=30'

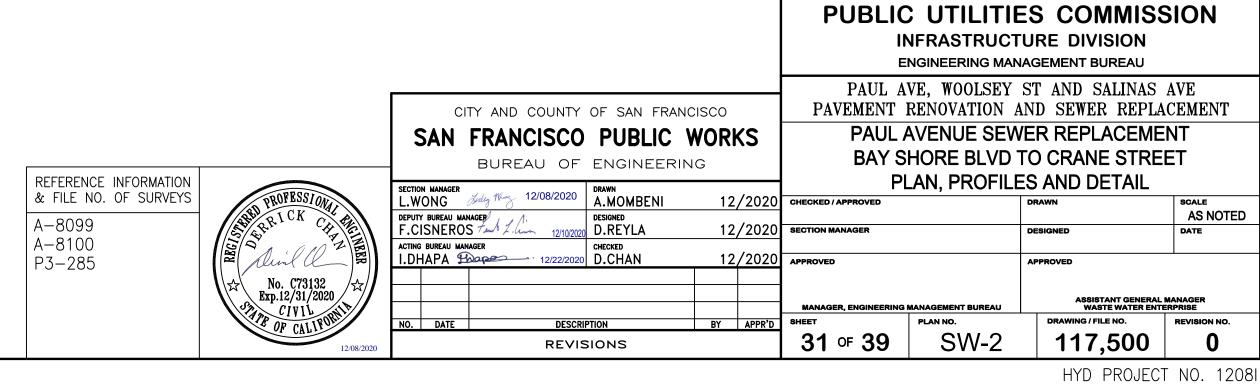

ELEVATION | SEWER SIZED BY DATUM APPROVED BY CITY HORIZONTAL SCALE: 1"=30' VERTICAL SCALE: 1"=10' CITY AND COUNTY OF SAN FRANCISCO