

PHASE 15 – SALINAS  
AVE AT CARR ST AND  
KEITH ST

☐ NO EXCEPTIONS TAKEN

☒ MAKE CORRECTIONS NOTED

☐ REJECTED

☐ REVISE AND RESUBMIT

☐ SUBMIT SPECIFIED ITEM(S)


Review is only for general conformance with the design concept of the project and general compliance with the requirements of the contract documents. Any action shown is subject to the requirements of the plans and specifications. Contractor's responsibilities include, but are not limited to actual dimensions which shall be confirmed and correlated at the job site; preferred fabrication processes and techniques of construction; coordination of the contractor's work with that of all other trades; and the satisfactory performance of the contractor's work.

Sustainable Streets Division

San Francisco Municipal Transportation Agency

City and County of San Francisco

By *do-s* Date **11/8/2021**

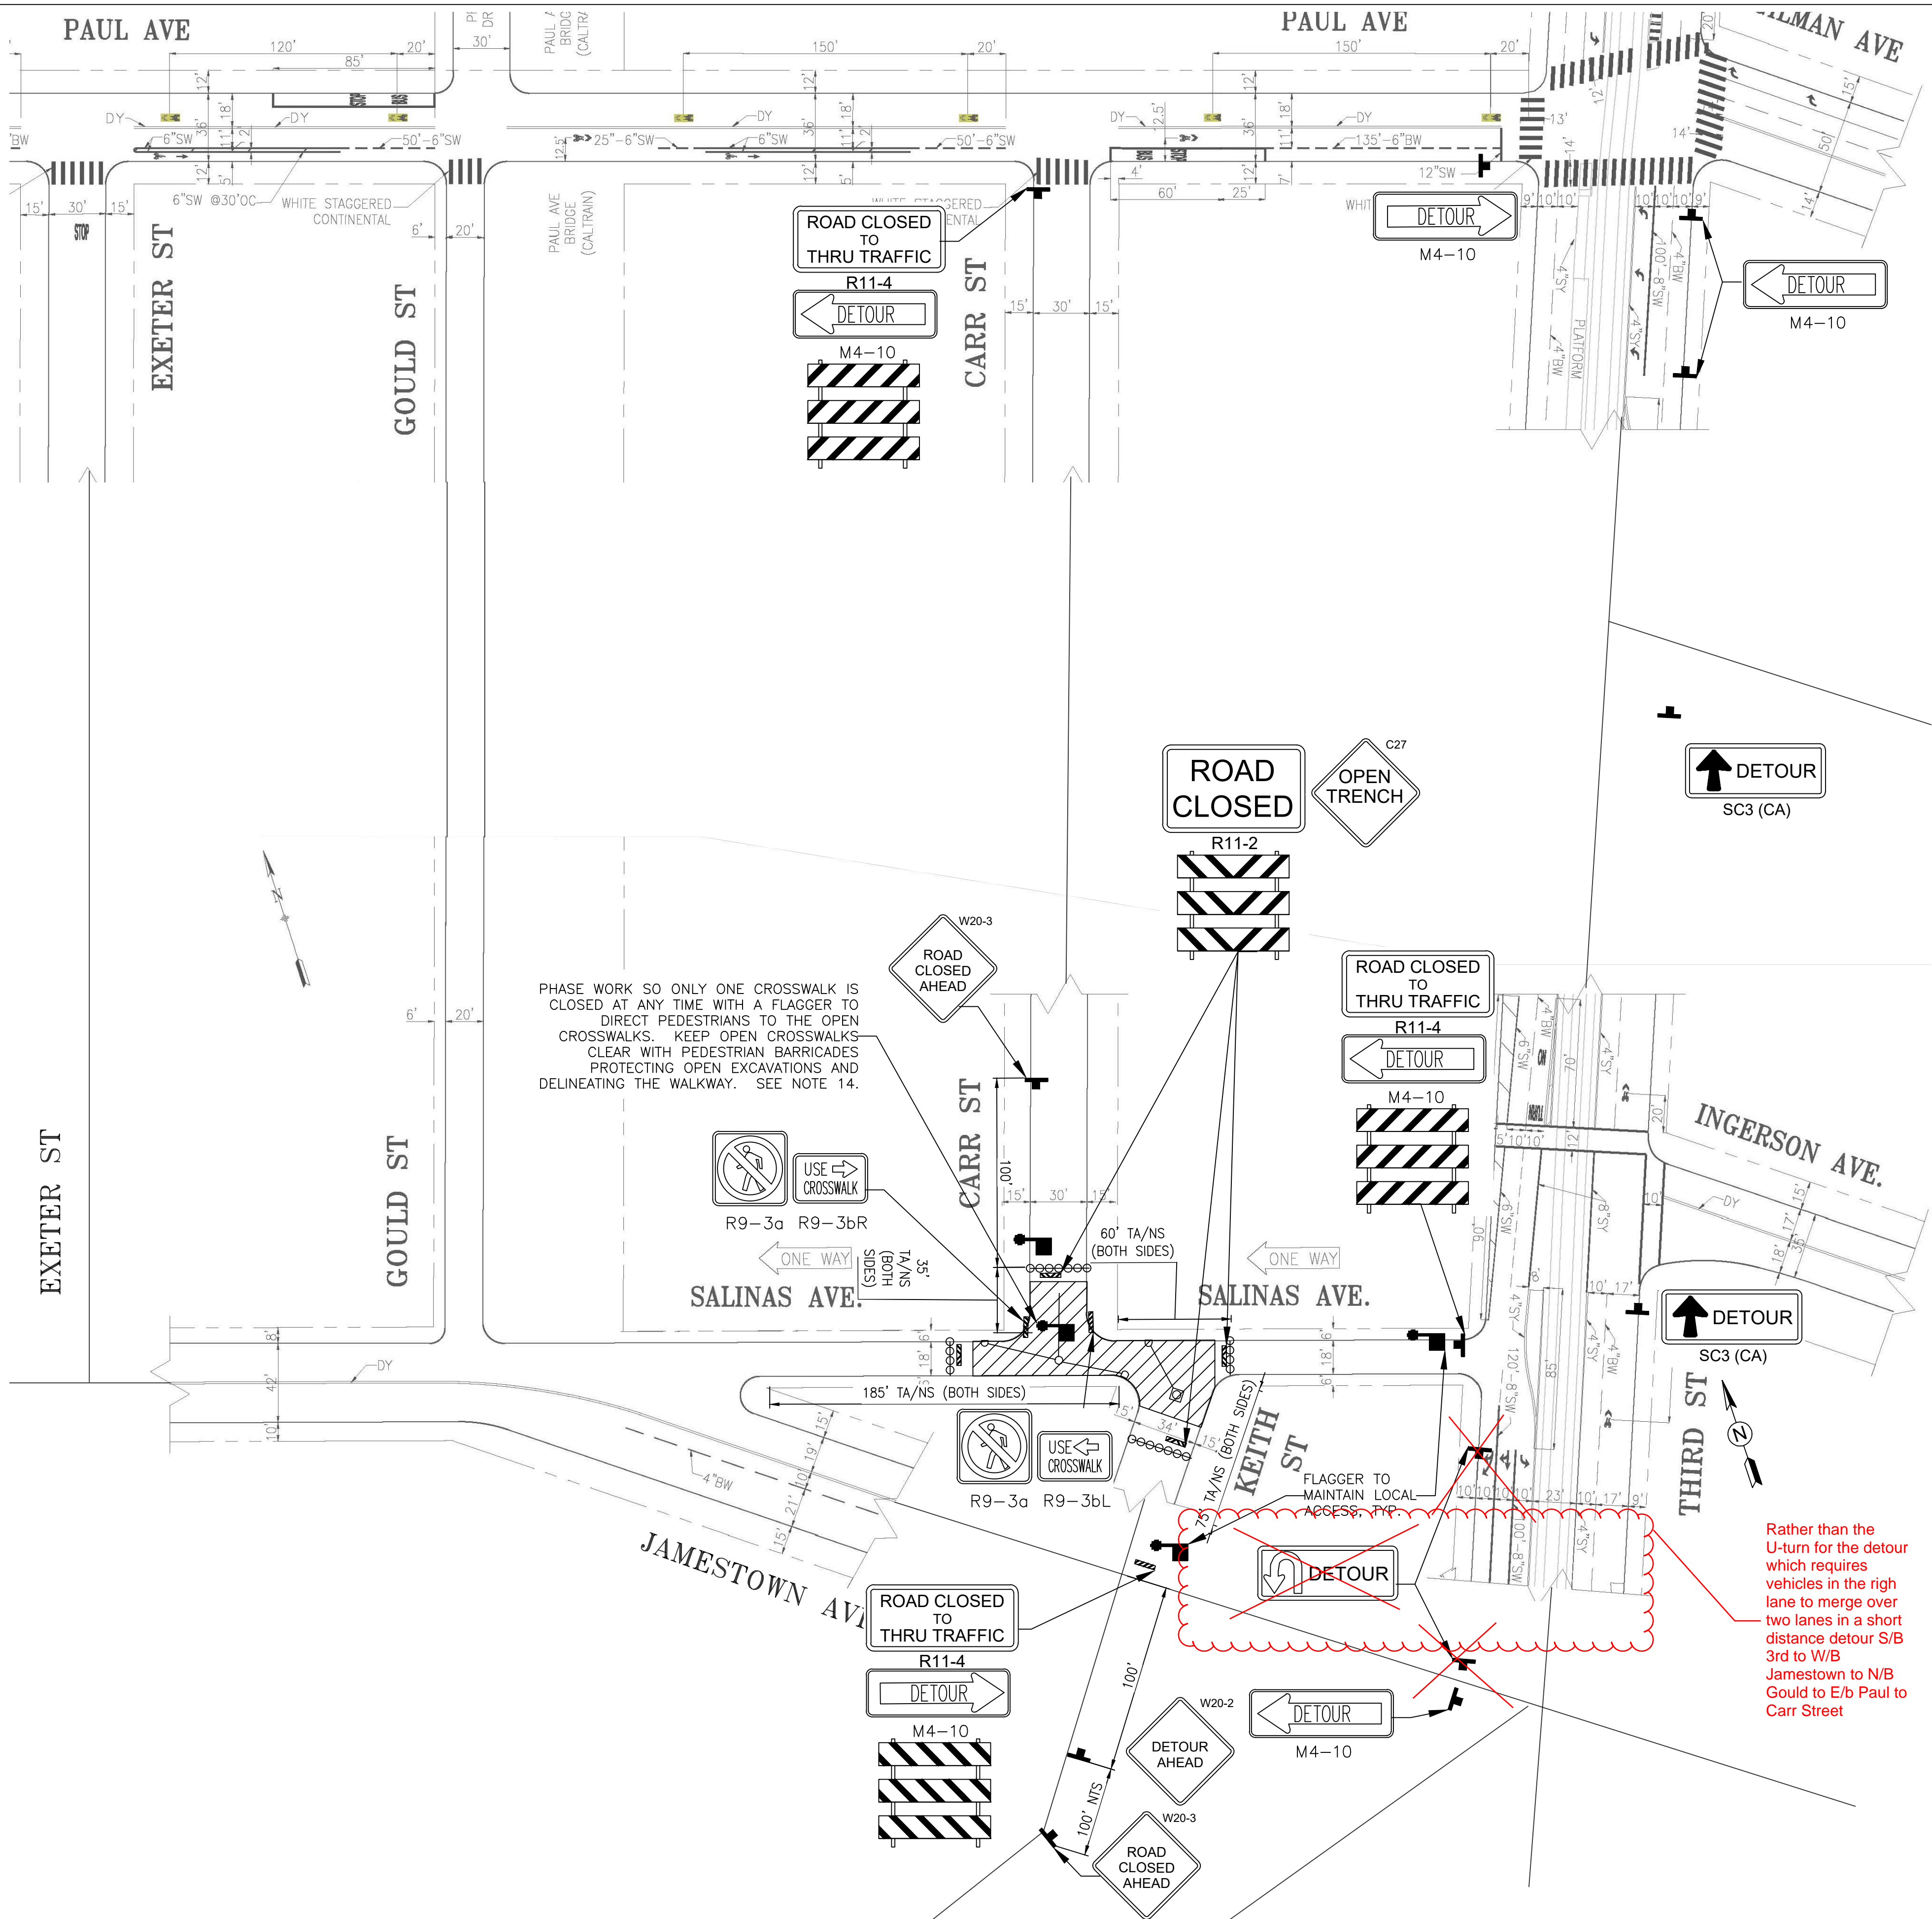

IF THIS SHEET IS NOT 24"x36" , IT IS  
A REDUCED PRINT – SCALE ACCORDINGLY

0 50 100 150  
1" = 50' GRAPHIC SCALE

Revisions				
No.	Revisions	By	Date	Appr.

BAY-CON INFRASTRUCTURE

PO BOX 1342

SAN MATEO CA 94401

(415) 580-1441 OFFICE

(415) 329-3240 FAX

INFO@BAY-CON.COM

Key Plan

This document is the property of the engineer and is not to be used without engineer's written permission. Satellite imagery provided by Google Earth and Europa Technologies.

Engineer Of Record:

PHIL MIESZKOWSKI, PE

11/1/2021

DESIGN DOCUMENTS  
TEMPORARY TRAFFIC CONTROL

Client  
MICHAEL O'SHAUGHNESSY CONSTRUCTION

Owner  
SAN FRANCISCO PUBLIC WORKS

Project  
SFPW 1000015860 PAUL AVE, WOOLSEY ST AND SALINAS AVE PAVEMENT RENOVATION AND SEWER REPLACEMENT

Sheet Title  
TEMPORARY TRAFFIC CONTROL PLAN FOR SEWER MAIN INSTALLATION ON PAUL AVE, WOOLSEY ST, AND SALINAS AVE – SHEET 13 OF 15

BGI Job 137	Sheet TCP-013
Drwn By PM	
Chckd By PM	
Issue Date 11/01/2021	