


PHASE 3 – WOOLSEY AVE AT DARTMOUTH ST – WORKING AND NON-WORKING HOURS

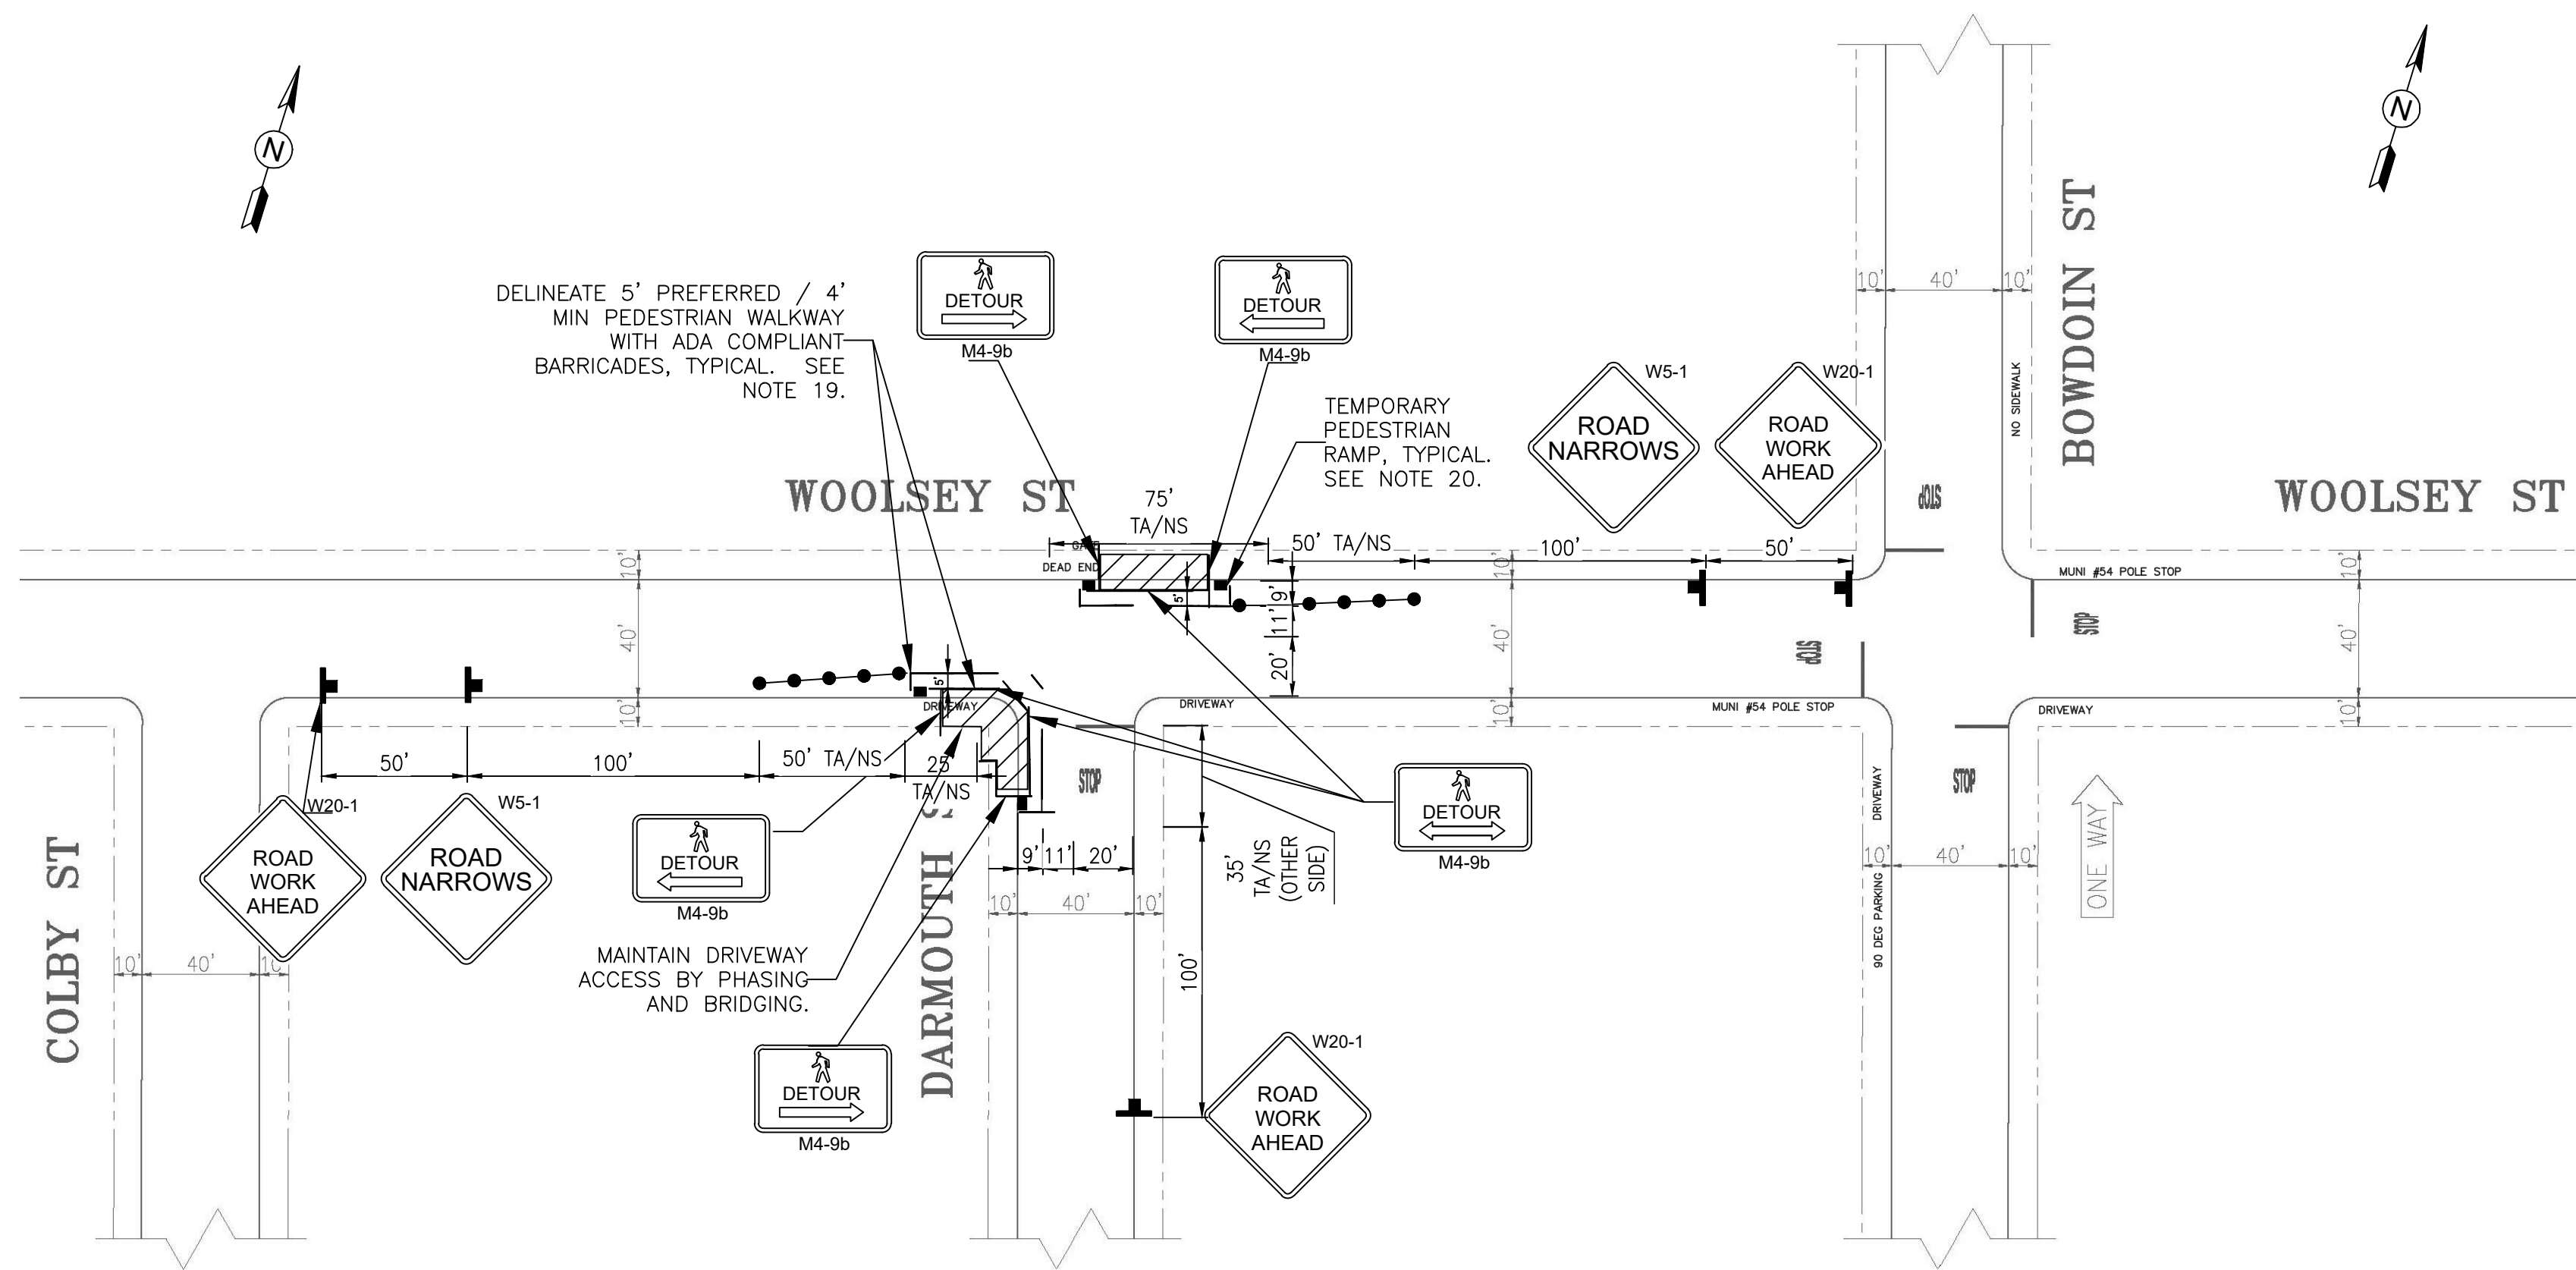


☒ NO EXCEPTIONS TAKEN  
☐ MAKE CORRECTIONS NOTED  
☐ REJECTED  
☐ REVISE AND RESUBMIT  
☐ SUBMIT SPECIFIED ITEM(S)

Review is only for general conformance with the design concept of the project and general compliance with the requirements of the contract documents. Any action shown is subject to the requirements of the plans and specifications. Contractor's responsibilities include, but are not limited to actual dimensions which shall be confirmed and correlated at the job site; preferred fabrication processes and techniques of construction; coordination of the contractor's work with that of all other trades; and the satisfactory performance of the contractor's work.

Sustainable Streets Division  
San Francisco Municipal Transportation Agency  
City and County of San Francisco

By *do-s* Date 1/6/2022

PHASE 4 – WOOLSEY AVE AT DARTMOUTH ST – WORKING AND NON-WORKING HOURS

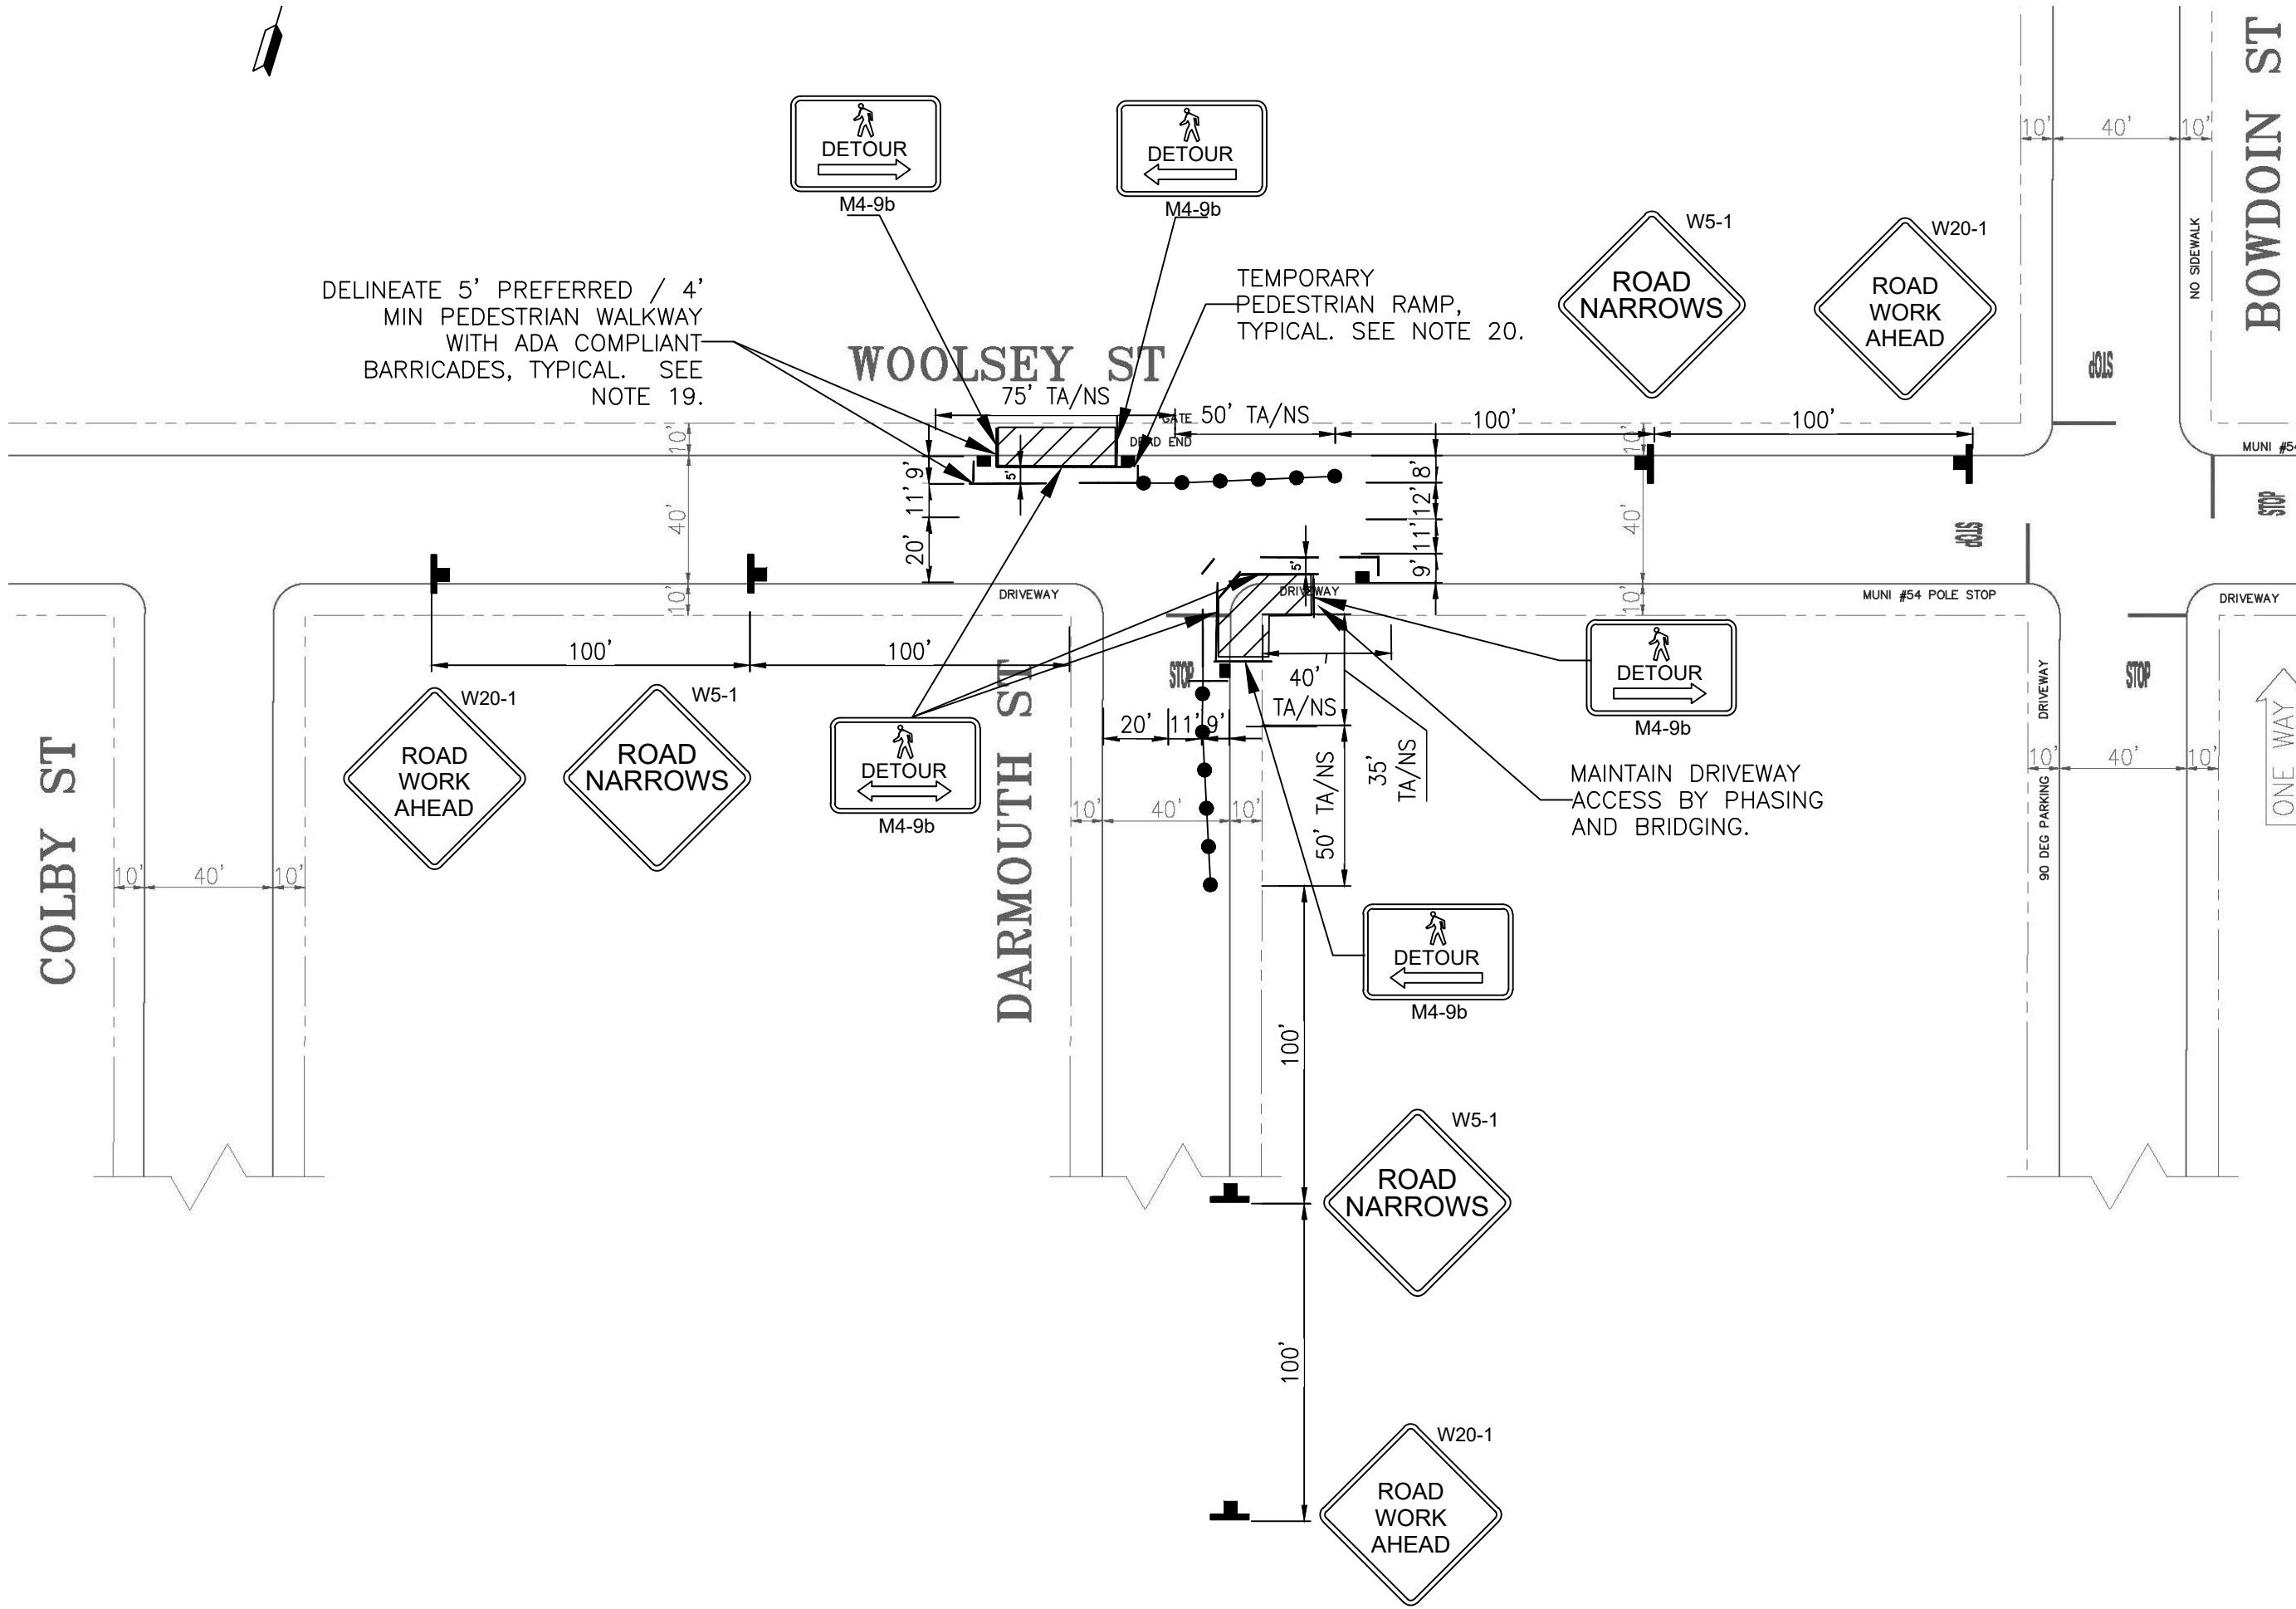

IF THIS SHEET IS NOT 24"x36" , IT IS  
A REDUCED PRINT – SCALE ACCORDINGLY

0 50 100 150  
1" = 50' GRAPHIC SCALE

Revisions				
No.	Revisions	By	Date	Appr.

**BAY-CON**  
INFRASTRUCTURE

BAY-CON INFRASTRUCTURE  
PO BOX 1342  
SAN MATEO CA 94401  
(415) 580-1441 OFFICE  
(415) 329-3240 FAX  
INFO@BAY-CON.COM

Key Plan

This document is the property of the engineer and is not to be used without engineer's written permission. Satellite imagery provided by Google Earth and Europa Technologies.

Engineer Of Record:  
PHIL MIESZKOWSKI, PE



12/2/2021

DESIGN DOCUMENTS  
TEMPORARY TRAFFIC CONTROL

Client  
MICHAEL O'SHAUGHNESSY CONSTRUCTION  
Owner  
SAN FRANCISCO PUBLIC WORKS  
Project  
SFPW 1000015860 PAUL AVE, WOOLSEY ST AND SALINAS AVE PAVEMENT RENOVATION AND SEWER REPLACEMENT

Sheet Title  
TEMPORARY TRAFFIC CONTROL PLAN FOR CURB RAMP CONSTRUCTION ON PAUL AVE, WOOLSEY ST, AND SALINAS AVE – SHEET 3 OF 15

BGI Job 137  
Drwn By PM  
Chckd By PM  
Issue Date 12/2/2021

Sheet  
TCP-018