


1.- SW-05 - 12" VCP Sewer on Crushed rock Bedding - 33 LF
2.- SW-05 - 12" VCP Sewer on Crushed rock Bedding - 31.5 LF
2.- SW-05 - 12" VCP Sewer on Crushed rock Bedding - 41 LF

TOTAL - SW-06 - 18" VCP Sewer on Crushed rock Bedding - 217 LF

TOTAL - SW-09 - 10" VCP Culvert - 145.7 LF


1.-	SW-14 - 6" or 8"	Diameter side sewer -	16.5 LF
2.-	SW-14 - 6" or 8"	Diameter side sewer -	16.5 LF
3.-	SW-14 - 6" or 8"	Diameter side sewer -	16.5 LF
4.-	SW-14 - 6" or 8"	Diameter side sewer -	16.5 LF
5.-	SW-14 - 6" or 8"	Diameter side sewer -	16.5 LF
6.-	SW-14 - 6" or 8"	Diameter side sewer -	16.5 LF

SW-17 - Post Construction television - 7 Each

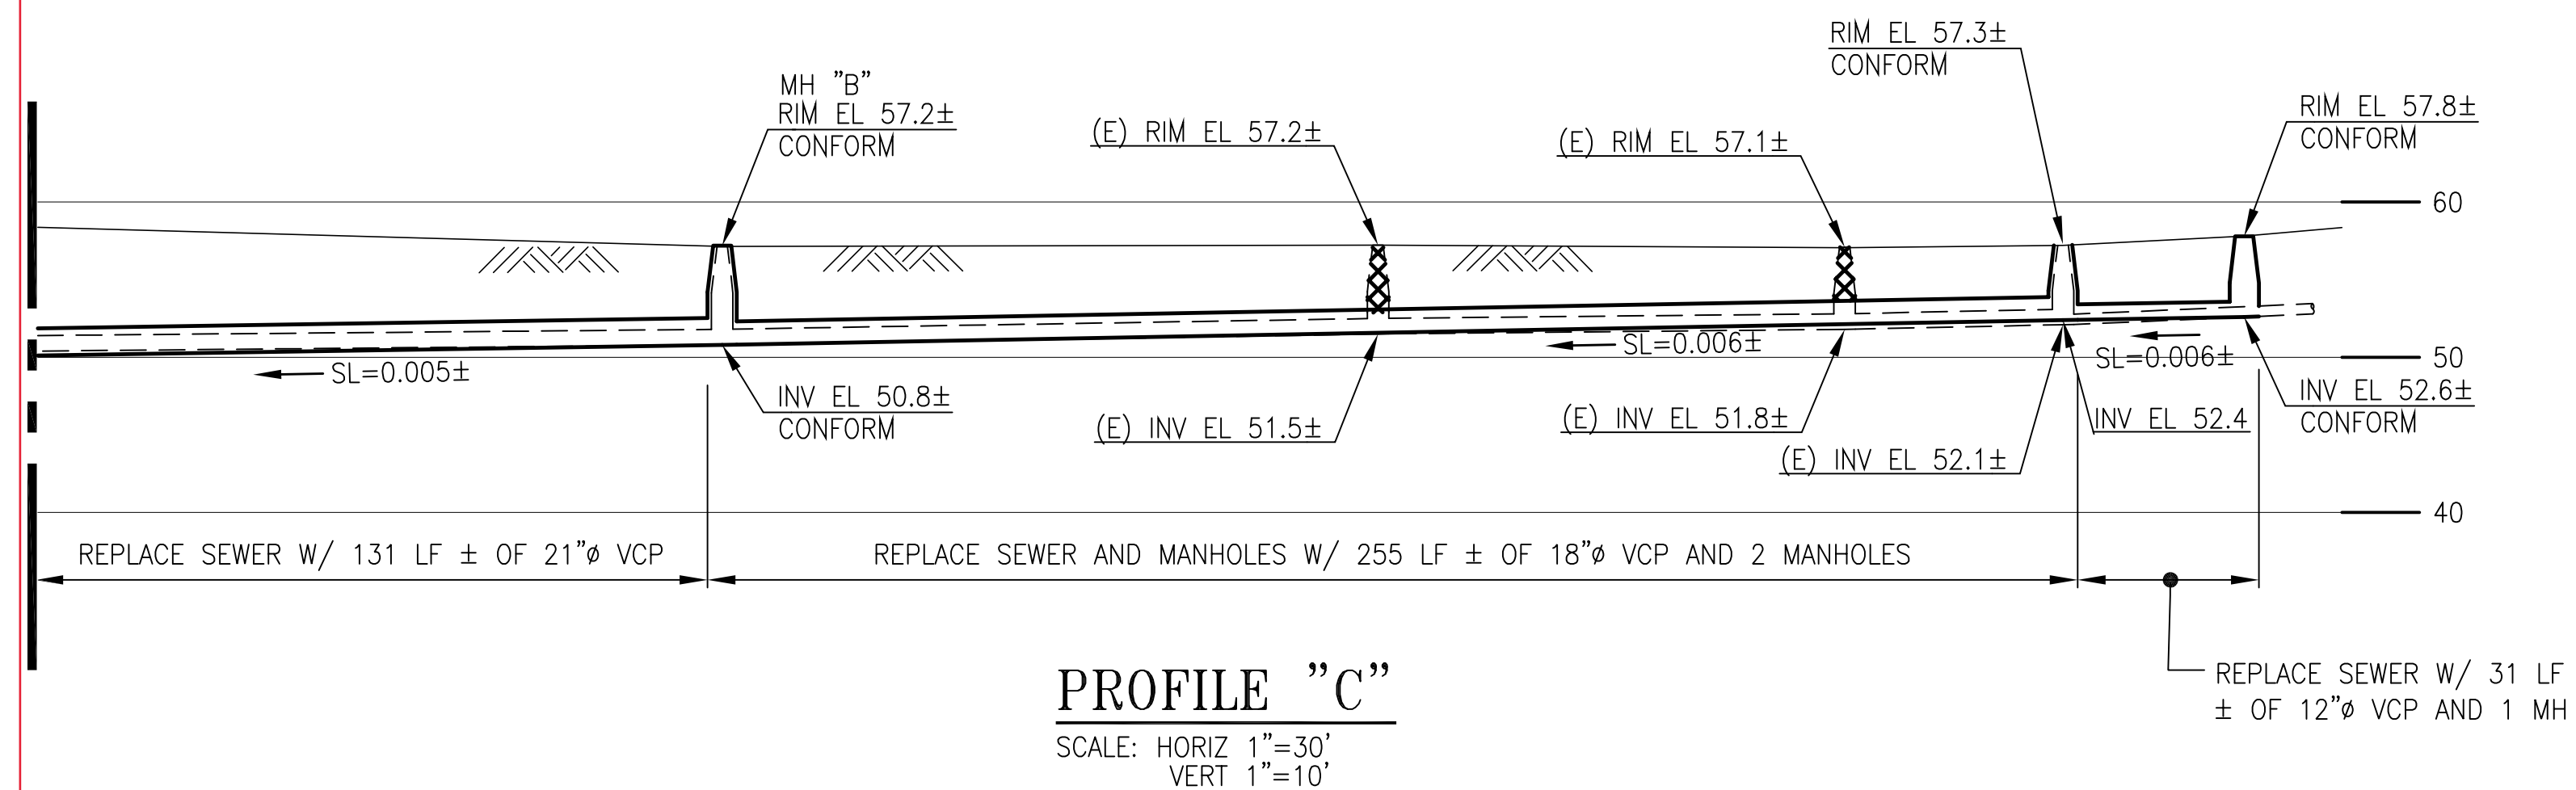


HYD PROJECT NO. 1208I

ELEVATION DATUM	SEWER SIZED BY J.F.
CITY	APPROVED BY N.B.

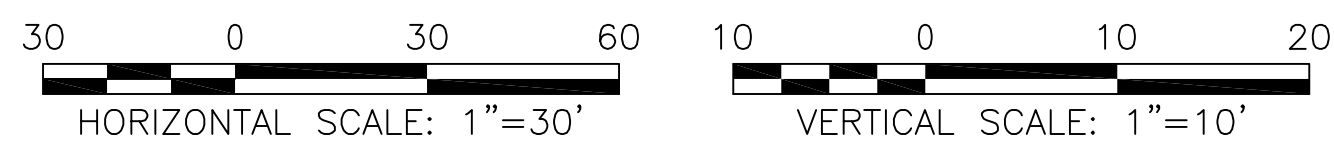

REFERENCE INFORMATION & FILE NO. OF SURVEYS
A-8099
A-8100
P3-285

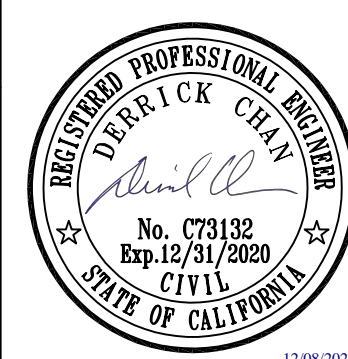

CITY AND COUNTY OF SAN FRANCISCO			
SAN FRANCISCO PUBLIC WORKS			
BUREAU OF ENGINEERING			
SECTION MANAGER L. WONG <i>Linda Wong</i> 12/08/2020		DRAWN A. WOMBENI 12/20/2020	
DEPUTY BUREAU MANAGER F. CISNEROS <i>Fred Cisneros</i> 12/10/2020		DESIGNED D. REYLA 12/2/2020	
ACTING BUREAU MANAGER I. DHAPA <i>Ishita Dhapa</i> 12/22/2020		CHECKED D. CHAN 12/2/2020	
NO.	DATE	DESCRIPTION	BY APPROV'D
REVISIONS			