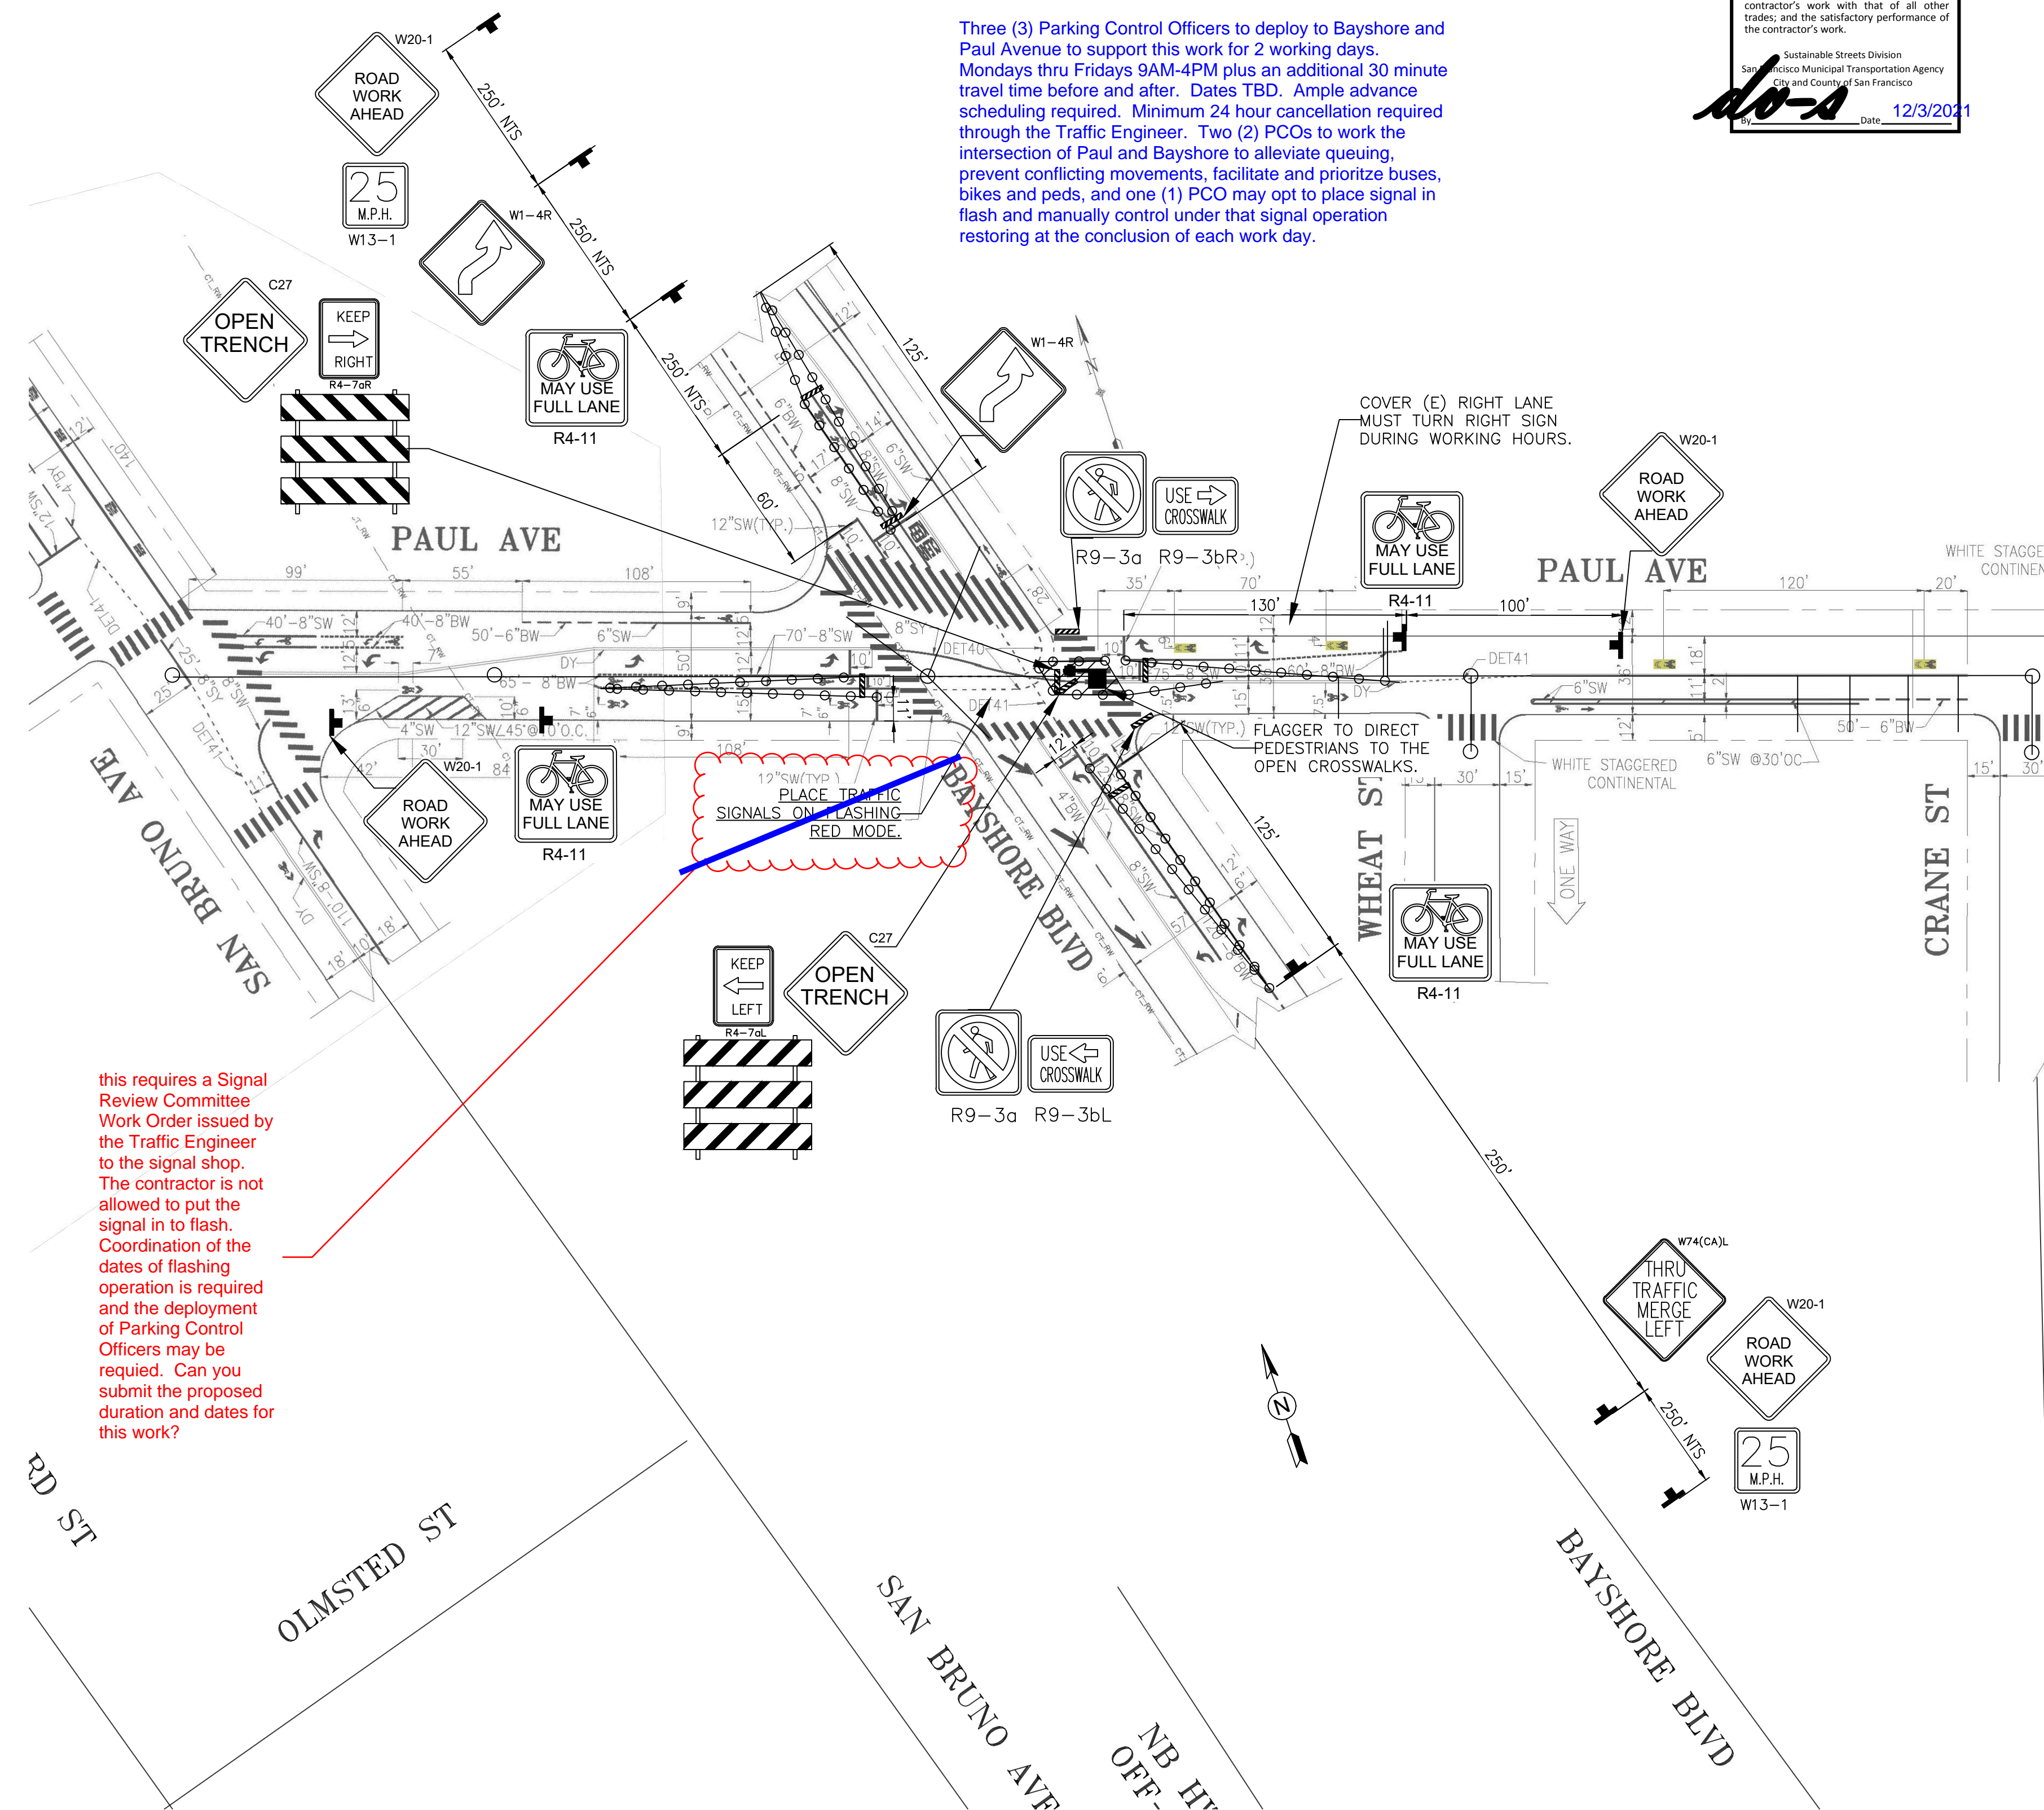


~~NO ACTION TAKEN~~

- ☒ NO EXCEPTIONS TAKEN
☐ MAKE CORRECTIONS NOTED
☐ REJECTED
☐ REVISE AND RESUBMIT
☐ SUBMIT SPECIFIED ITEM(S)
- Review is only for general conformance with the general concept of the project and general compliance with the requirements of the contract documents. Any action shown is restricted to the requirements of the plans and specifications. Contractor's responsibilities include, but are not limited to actual dimensions which shall be confirmed and correlated at the job site; preferred fabrication processes and techniques of construction; coordination of the contractor's work with that of all other trades; and the satisfactory performance of the contractor's work.
- Sustainable Streets Division
 San Francisco Municipal Transportation Agency
 City and County of San Francisco
- By 12/3/20 Date, 12/3/20

this requires a Signal Review Committee Work Order issued by the Traffic Engineer to the signal shop. The contractor is not allowed to put the signal in to flash. Coordination of the dates of flashing operation is required and the deployment of Parking Control Officers may be required. Can you submit the proposed duration and dates for this work?

[illegible]

Key Plan

Engineer Of Record:

PHIL MIESZKOWSKI, PE



11/1/2021

DESIGN DOCUMENTS
TEMPORARY TRAFFIC CONTROL

Client
MICHAEL O'SHAUGHNESSY CONSTRUCTION
Owner
SAN FRANCISCO PUBLIC WORKS
Project
SFPW 1000015860 PAUL AVE, WOOLSEY ST
AND SALINAS AVE PAVEMENT RENOVATION
AND SEWER REPLACEMENT

Sheet Title
TEMPORARY TRAFFIC CONTROL PLAN FOR
SEWER MAIN INSTALLATION ON PAUL AVE,
WOOSLEY ST, AND SALINAS AVE - SHEET 5
OF 15

BCI Job 137

Drwn By PM

Chckd By PM

Issue Date 11/01/2021

Sheet
TCP-005