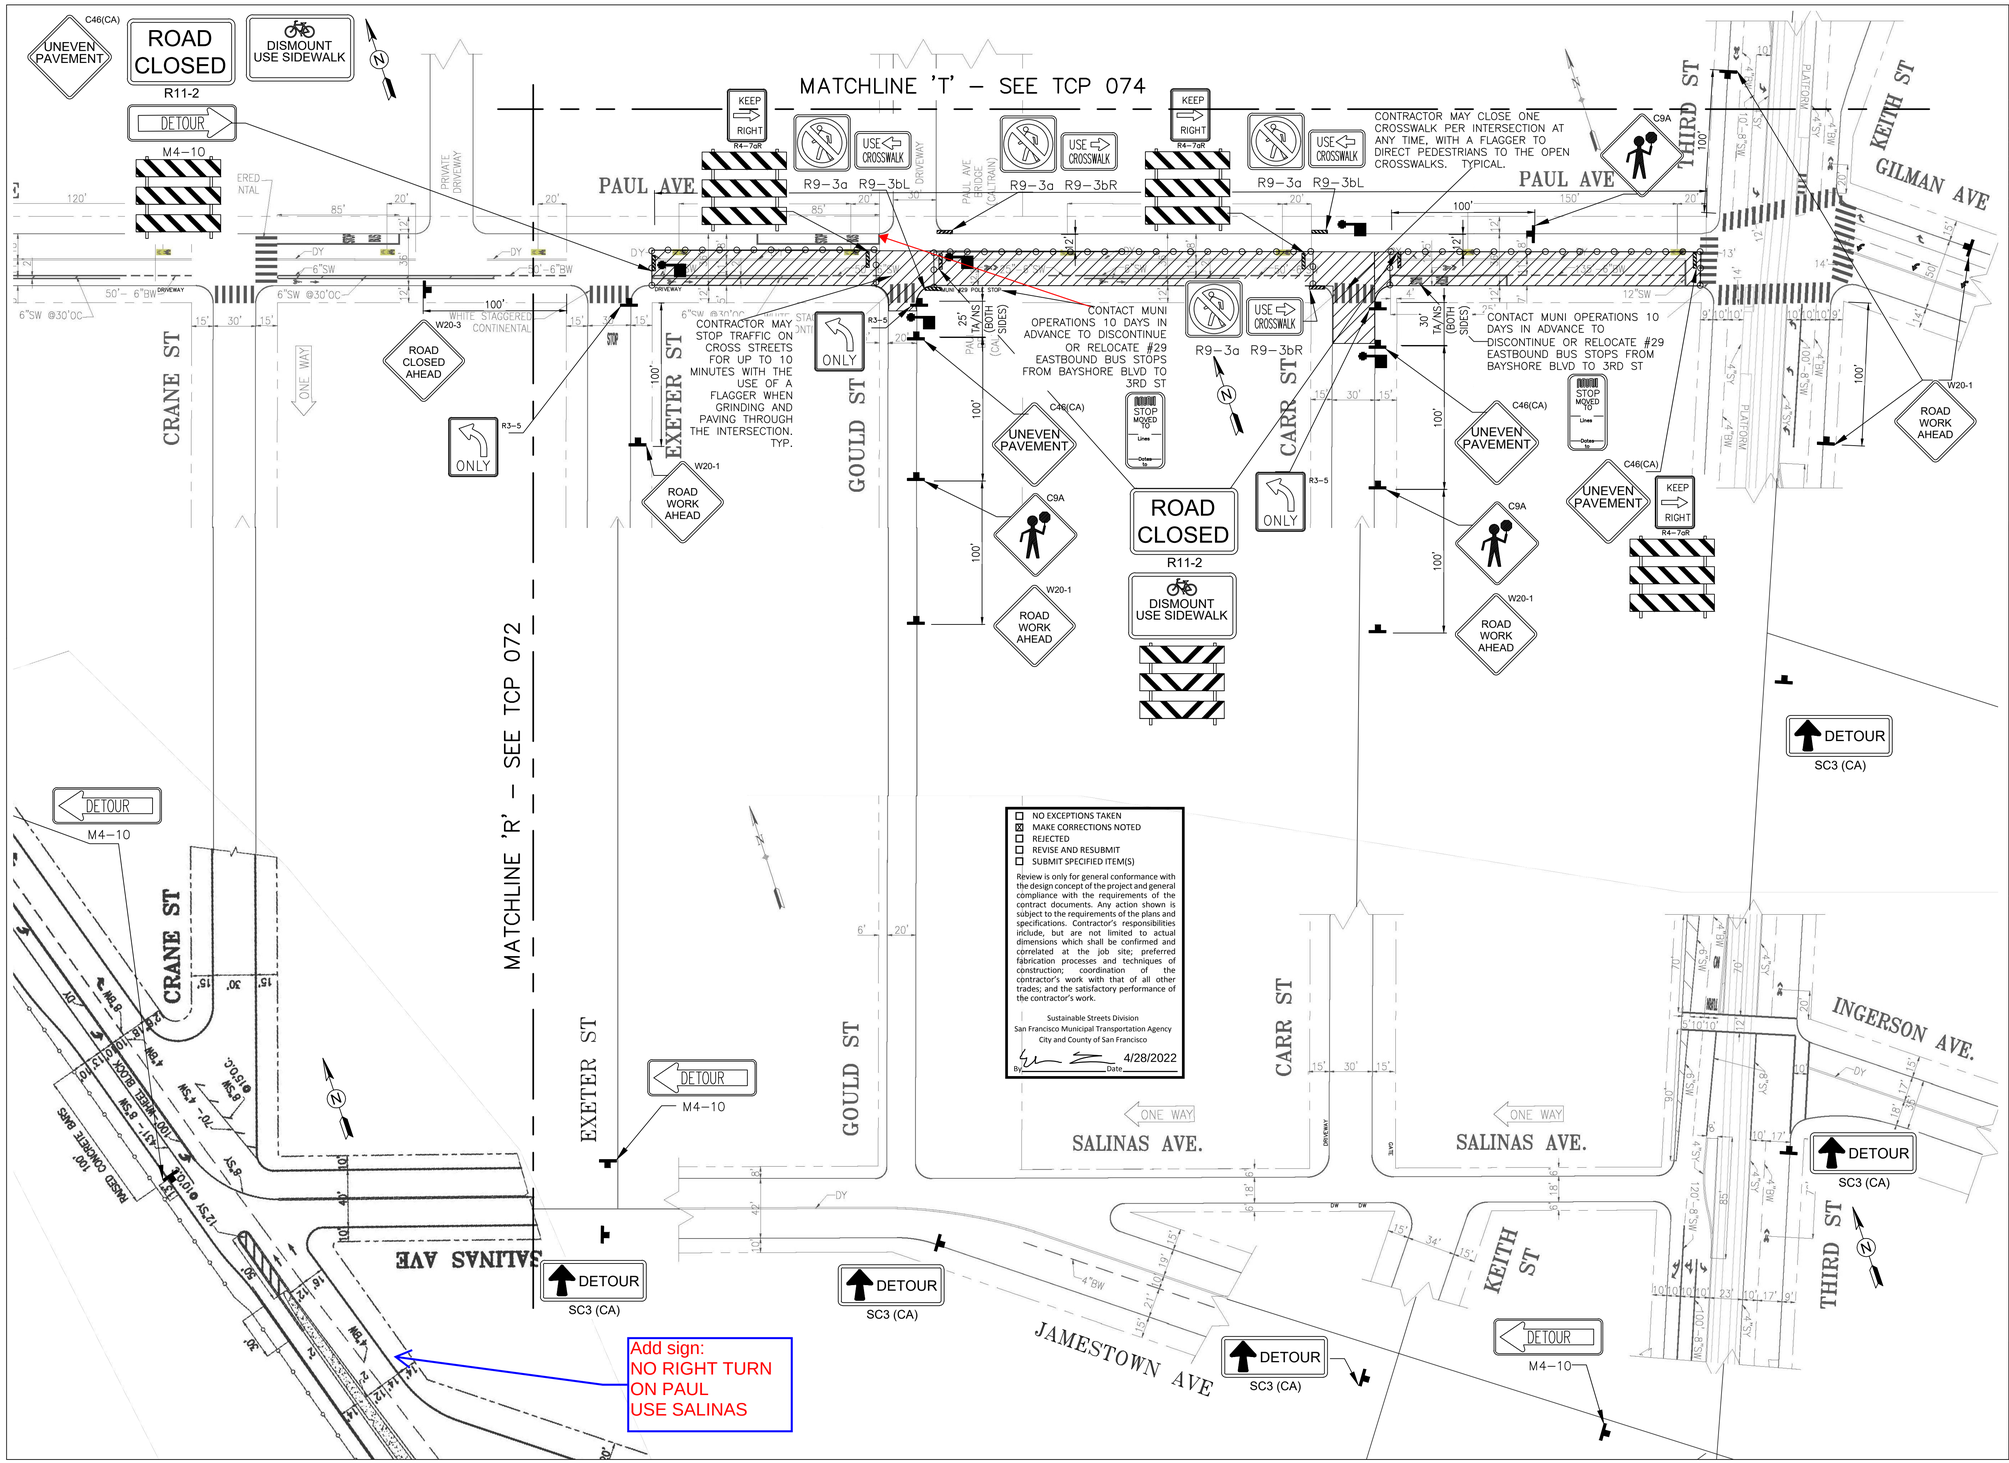

- ☐ NO EXCEPTIONS TAKEN
- ☒ MAKE CORRECTIONS NOTED
- ☐ REJECTED
- ☐ REVISE AND RESUBMIT
- ☐ SUBMIT SPECIFIED ITEM(S)

Review is only for general conformance with the design concept of the project and general compliance with the requirements of the contract documents. Any action shown is subject to the requirements of the plans and specifications. Contractor's responsibilities include, but are not limited to actual dimensions which shall be confirmed and correlated at the job site; preferred fabrication processes and techniques of construction; coordination of the contractor's work with that of all other trades; and the satisfactory performance of the contractor's work.

Sustainable Streets Division
San Francisco Municipal Transportation Agency
City and County of San Francisco

By _____ Date 4/28/2022

IF THIS SHEET IS NOT 24"x36" , IT IS A REDUCED PRINT – SCALE ACCORDINGLY

0 50 100 150
1" = 50' GRAPHIC SCALE

Revisions

No.	Revisions	By	Date	Appr.

BAY-CON INFRASTRUCTURE
PO BOX 1342
SAN MATEO CA 94401
(415) 580-1441 OFFICE
(415) 329-3240 FAX
INFO@BAY-CON.COM

Key Plan

This document is the property of the engineer and is not to be used without engineer's written permission. Satellite imagery provided by Google Earth and Europa Technologies.

Engineer Of Record:
PHIL MIESZKOWSKI, PE

REGISTERED PROFESSIONAL ENGINEER PHILLIP M. MIESZKOWSKI C 76768 EXP. 12/31/2022 CIVIL STATE OF CALIFORNIA

3/23/2022

DESIGN DOCUMENTS
TEMPORARY TRAFFIC CONTROL

Client
MICHAEL O'SHAUGHNESSY CONSTRUCTION

Owner
SAN FRANCISCO PUBLIC WORKS

Project
SFPW 1000015860 PAUL AVE, WOOLSEY ST AND SALINAS AVE PAVEMENT RENOVATION AND SEWER REPLACEMENT

Sheet Title
TEMPORARY TRAFFIC CONTROL PLAN FOR ASPHALT GRIND & PAVE ON PAUL AVE AND SALINAS AVE – SHEET 13 OF 18

BCI Job 137
Drwn By PM
Chckd By PM
Issue Date 3/23/2022

Sheet
TCP-073

73, 3/23/2022 2:27:02 PM